


 WorleyParsons <small>resources & services</small> Performance Specifications For Inlet Separator	 Z-PAD GPP GAS PARTIAL PROCESSING PLANT	DOCUMENT NO. TD-SPC-001	REV. EF	DATE 06/07/2723/07	PAGE OF 2 7
--	--	-----------------------------------	-------------------	------------------------------	----------------

Table of Contents

<u>Section</u>	<u>Page</u>
1 Introduction	3
2 Production Stream Data	3
3 Vessel Design Criteria	3
Table 3.1- Inlet Separator Operating Suction Pressure and Compressor Capacity	4
4 Vessel Internal s Criteria	4
Table 4.1- Inlet Separator (VSP-Z6011) Feed -Stream Data	56
 Appendix	
A. Process Flow Diagram	FS-WPZ-0006 Sheet 1
B. Vessel Datasheet of the Inlet Separator	DAS-TD-VSP-Z6011
C. Vessel Datasheet of the 1 st Stage Scrubber	DAS-TD-VS-Z6001
D. Inlet Separator Feed Preliminary Isometric	IS-WPZ-05441-001

 WorleyParsons <small>resources & services</small>		Z-PAD GPP GAS PARTIAL PROCESSING PLANT	DOCUMENT NO.	REV.	DATE	PAGE OF
			TD-SPC-001	EF	06/07/2723/07	3 7

Performance Specifications
For Inlet Separator

1. Introduction

The crude oil productions from several oil pads in the Western Region Development areas are gathered at Z-Pad. The total production stream enters the ~~Inlet Separator~~ **Inlet Separator (VSP-Z6011)** of the Gas Partial Processing (GPP) facility, where gas and liquid are disengaged.

2. Production Stream Data

The total crude oil production will vary over time. The projected production capacities for year 2011, 2015, and 2019 are chosen to define the design basis for the GPP. The production rates and stream data for these three years are shown in ~~Table 4~~ **Table 4.1**.



The production stream carries certain amount of sand particles which also varies over time. The expected sand rate increases from ~~20-10~~ cubic yards a day initially to approximately ~~40-30~~ cubic yards a day beyond Year 2019.

The ~~hydrogen sulfide (H₂S) content of the gas will be 20 ppm initially and could rise to gas-is-expected-to contain as much as 200 ppm of H₂S.~~ **hydrogen sulfide (H₂S). 50 to 80 MMSCFD of gas out of the Inlet Separator (VSP-Z6011) is bypassed around the plant to the outlet liquid line. The remaining gas goes to the 1st Stage Scrubber (VS-Z6001). The liquid entrainment amount in the gas, leaving the Inlet Separator (VSP-Z6011), is not as critical as the liquid entrainment amount out of the 1st Stage Scrubber (VS-Z6001) which feeds a compressor.**

The Process Flow Diagrams (PFDs) of the GPP are appended at the end of this document.

3. Vessel Design Criteria

- 3.1 The ~~Inlet Separator~~ **Inlet Separator (VSP-Z6011)** is designed to achieve good separation of gas and liquid. Since the total liquid production leaving the vessel shall be returned to the production pipeline, separation of oil and water is not required. The ~~Inlet Separator~~ **Inlet Separator (VSP-Z6011)** is to be design according to the Vessel Datasheet located in Appendix B. All operating and alarm levels as well as the weir height are indicative only. Internal vendor to optimize the levels to maximize the surge volume and to specify Low, Normal and High liquid levels that better suite their internal device selection.
- 3.2 The Feed stream of the ~~Inlet Separator~~ **Inlet Separator (VSP-Z6011)** is shown in ~~Table 4~~ **Table 4.1** for typical operating years.
- 3.3 The ~~4st Stage Scrubber~~ **1st Stage Scrubber (VS-Z6001)** is designed to achieve good separation of liquid carry over in order to protect downstream compressor against liquid impingement. The ~~4st Stage Scrubber~~ **1st Stage Scrubber (VS-Z6001)** is to be design according to the Vessel Datasheet located in Appendix C.
- 3.4 The separated gas of the ~~Inlet Separator~~ **Inlet Separator (VSP-Z6011)** is feeding the ~~4st Stage Scrubber~~ **1st Stage Scrubber (VS-Z6001)**. However the gas rate is dictated by the compressor capacity with the excess separated gas sent via the excess gas bypass line to the pipeline to GC-2.

 WorleyParsons <small>resources & services</small>		Z-PAD GPP GAS PARTIAL PROCESSING PLANT	DOCUMENT NO.	REV.	DATE	PAGE OF
			TD-SPC-001	EF	06/07/27-23/07	4 7

Performance Specifications
For Inlet Separator

The compressor capacity is ~~depending~~ **dependent** on the operation suction pressure and it is anticipated to operate as follows:

Table 3.1 - Inlet Separator Operating Suction Pressure and Compressor Capacity

Year	Inlet Separator Pressure	Compressor Capacity
2011	350 psig	410 MMSCFD
2015	250 Psig	350 MMSCFD
2019	250 Psig	350 MMSCFD

4. Vessel Internals Criteria

4.1 The ~~Inlet Separator~~ **Inlet Separator (VSP-Z6011)** vessel must be equipped with appropriate internals to mitigate foam formation and emulsion, as the crude oil is expected to be becoming colder and more viscous over time. The following internals are to be considered:

- Cyclone Inlet Devices
- Vane Pack Defoamer (if necessary)
- Perforated Baffles
- Demister Pad ~~/~~ or Outlet Device **of other design**
- Sand Jet Removal System



Final selection of the internal is left to vendor.

4.2 ~~Inlet Separator~~ **Inlet Separator (VSP-Z6011)**: Slugs can arise in the production pipeline in irregular frequency and enter the vessel over a period of time. The vessel must be designed to handle a slug size of up to **580** barrels flowing at 100 ft/s. The slug is considered to ride on the normal production flow. The vessel and all internals must be strengthened to withstand the impact forces of an indefinite number of slug occurrences.

4.3 ~~Inlet Separator~~ **Inlet Separator (VSP-Z6011)**: The inlet stream is preferred to enter from the top at one end of the vessel and the vapor stream exits the vessel from the other end. Current piping layout provides 15' of ~~strait~~ **strait** 36" horizontal run in the axis of the Separator upstream of the inlet elbow down. The elbow upstream of the run is in the horizontal plane. Vendor to advise if different piping configuration is warranted.

4.4 ~~Inlet Separator~~ **Inlet Separator (VSP-Z6011)**: The vessel must include appropriate sand jetting system to remove sand accumulation. Currently there is no plan to dispose the sand locally at Z-pad. The slurry exiting the vessel shall be pumped and routed to the production pipeline along with the separated heated liquids and the excess gas.

Volume upstream of the suggested 18" weir should be sufficient to accommodate up to 20 cubic yard of sand. Motive water for the sand jetting system is derived from the water injection line that will be put in place during the Phase I of the GPP project. On higher sand loading, sand jetting will be scheduled more than once a day. **Vendor to advise on sand weir height and location.**

 WorleyParsons <small>resources & services</small> Performance Specifications For Inlet Separator	 Z-PAD GPP GAS PARTIAL PROCESSING PLANT	DOCUMENT NO. TD-SPC-001	REV. EF	DATE 06/27/2007	PAGE OF 5 7
--	---	-----------------------------------	-------------------	---------------------------	----------------

4.5 ~~1st Stage Scrubber~~ 1st Stage Scrubber (VS-Z6001):

4.5.1 For the outlet gas leaving the ~~1st Stage Scrubber~~ 1st Stage Scrubber (VS-Z6001), liquid entrainment should be limited to less than 10 micron droplets.

4.5.2 Maximum design liquid rate of 100 gallons per minute for start-up and upset condition.

4.6 Vendor to identify maximum liquid accumulation rate in the 1st Stage Scrubber (VS-Z6001) based on the proposed internals of the Inlet Separator (VSP-Z6011).

4.7 Size of the vessels identified in the vessel datasheets are the maximum anticipated requirement. Vendor can suggest reducing the size of the vessels provided that the internal design and performance allow and warrant it.

4.8 The maximum allowed total pressure drop of both Inlet Separator (VSP-Z6011) and 1st Stage Scrubber (VS-Z6001) ~~between the internal of the two vessels~~ is 5 psi which includes inlet and outlet nozzle-to-nozzle in addition to all internals.

4.9 Vendor to design inlet device to 1st Stage Scrubber (VS-Z6001).





 WorleyParsons <small>resources & services</small>		Z-PAD GPP GAS PARTIAL PROCESSING PLANT	DOCUMENT NO.	REV.	DATE	PAGE OF
			TD-SPC-001	EF	0607/2723/07	6 7
Performance Specifications For Inlet Separator						

Table 4.1- Inlet Separator (VSP-Z6011) Feed Stream Data

	Year 2011	Year 2015	Year 2019
	Total Production @ Z-Pad	Total Production @ Z-Pad	Total Production @ Z-Pad
TOTAL STREAM:			
Phase	MIXED	MIXED	MIXED
Vapour Fraction	0.329	0.292	0.252
Temperature, °F	105	105.1	105.1
Pressure, psia	364.7	264.7	264.7
Molar Flow, Lbmol/h	151,874	158,803	183,537
Mass Flow, Lb/h	4,142,699	4,080,666	4,348,076
Molecular Weight	27.28	25.70	23.69
Heat Flow, MMBTU/h	-15288.2	-16440.0	-19440.2
VAPOR PHASE:			
Mass Flow, Lb/h	1,094,685	1,113,778	1,155,896
Actual Gas Flow, ACFM	12,993	16,694	16,597
Standard Gas Flow, MMSCFD	455.49	421.83	421.46
Molecular Weight	21.888	24.047	24.978
Z Factor	0.938	0.939	0.934
Mass Enthalpy, BTU/Lb	-2184.99	-2108.85	-2091.43
Mass Density, Lb/ft3	1.404	1.112	1.161
Mass Heat Capacity (Cp), BTU/Lb-°F	0.484	0.461	0.456
Cp/Cv	1.334	1.298	1.293
Thermal Conductivity, BTU/h-ft-°F	0.019	0.018	0.018
Viscosity, cp	0.013	0.012	0.012
MIXED LIQUID PHASE:			
Mass Flow, Lb/h	3,048,014	2,966,888	3,192,181
Actual Liquid Flow, GPM	6,473.2	6,234.9	6,624.8
Standard Liquid Volume Flow, BPD	218,780	211,048	224,602
Mass Enthalpy, BTU/Lb	-4,231.02	-4,749.45	-5,332.58
Mass Density, Lb/ft3	58.71	59.33	60.08
Mass Heat Capacity, BTU/Lb-°F	0.768	0.817	0.872
Thermal Conductivity, BTU/h-ft-°F	0.179	0.210	0.247
Viscosity, cp	71.06	34.41	1.06
Surface Tension, dyne/cm	---	---	---
HYDROCARBON LIQUID PHASE:			
Mass Flow, Lb/h	1,326,611	1,026,662	785,913
Actual Liquid Flow, GPM	3,006.5	2,327.4	1,778.7
Standard Liquid Volume Flow, BPD	100,737	78,000	59,595
Molecular Weight	210.30	214.50	212.90
Mass Enthalpy, BTU/Lb	-936.61	-930.85	-931.44
Mass Density, Lb/ft3	55.013	54.997	55.087
Mass Heat Capacity, BTU/Lb-°F	0.456	0.455	0.455
Thermal Conductivity, BTU/h-ft-°F	0.071	0.072	0.071
Viscosity, cp	13.02	13.78	14.31
Surface Tension, dyne/cm	20.58	20.87	20.33
AQUEOUS LIQUID PHASE:			
Mass Flow, Lb/h	1,721,403	1,940,226	2,406,268
Actual Liquid Flow, GPM	3,466.7	3,907.5	4,846.0
Standard Liquid Volume Flow, BPD	118,043	133,049	165,007
Mass Enthalpy, BTU/Lb	-6769.88	-6770.05	-6770.05
Mass Density, Lb/ft3	61.91	61.91	61.91
Mass Heat Capacity, BTU/Lb-°F	1.008	1.009	1.009
Thermal Conductivity, BTU/h-ft-°F	0.365	0.365	0.365
Viscosity, cp	0.64	0.64	0.64
Surface Tension, dyne/cm	69.40	69.39	69.39

 WorleyParsons <small>resources in motion</small> Performance Specifications For Inlet Separator	 Z-PAD GPP GAS PARTIAL PROCESSING PLANT	DOCUMENT NO. TD-SPC-001	REV. EF	DATE 06/27/2007	PAGE OF 7 7
---	---	-----------------------------------	-------------------	---------------------------	----------------

Appendix

A. Process Flow Diagram

FS-WPZ-00006-001.pdf

B. Vessel Datasheet of the Inlet Separator (VSP-Z6011)


DAS-TD-VSP-Z6011 Inlet Separator-Rev D.pdf

C. Vessel Datasheet of the 1st Stage Scrubber (VS-Z6001)

DAS-TD-VS-Z6001 1st Stage Suction Scrubber-Rev E.pdf

D. Inlet Separator Feed Preliminary Isometric

IS-WPZ-05441-001 WOA – ISOMETRIC 4/17/07

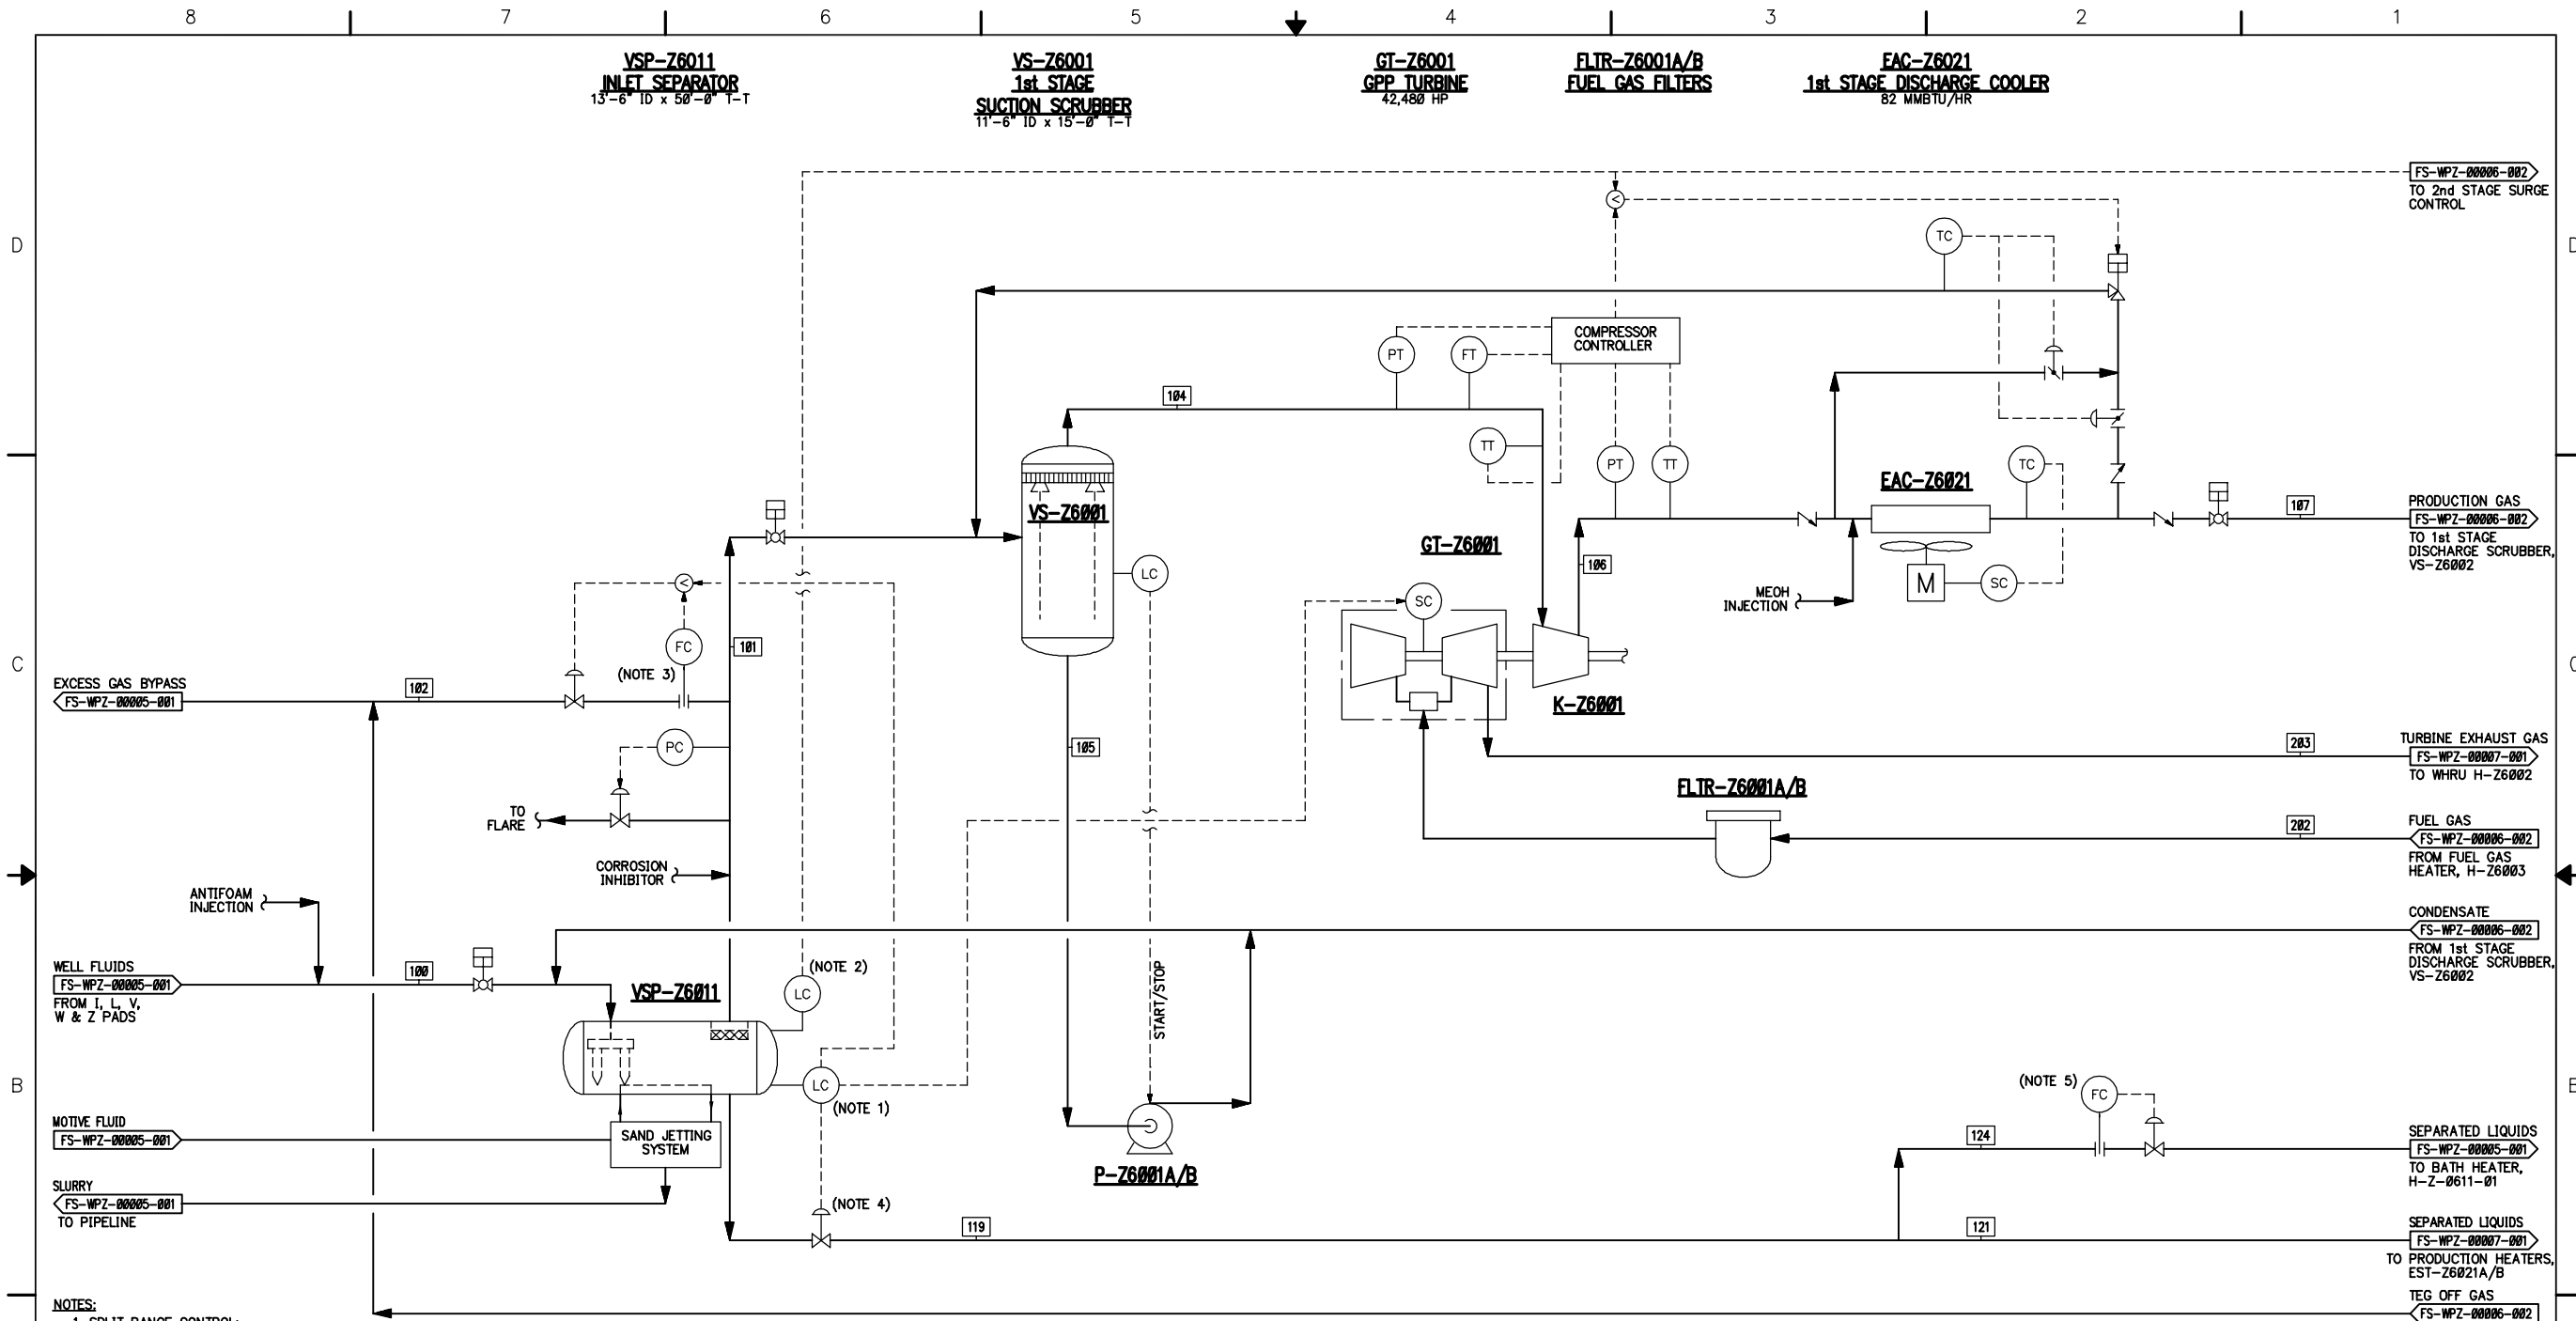

- NOTES:**
1. SPLIT RANGE CONTROL:
100-66% RAISES TURBINE SPEED AS LEVEL DROPS.
66-33% OPEN FEED GAS BYPASS AS LEVEL DROPS.
33-0% CLOSE LEVEL VALVE AS LEVEL DROPS.
 2. OPEN COMPRESSOR RECYCLE VALVES AS LEVEL RISES.
 3. THE FLOW CONTROLLER WILL OVERRIDE THE LEVEL CONTROL TO LIMIT GAS FLOW TO GC-2.
 4. LEVEL VALVE IS NORMALLY FULLY OPEN.
 5. BETWEEN 2011 AND 2016, FLOW TO BATH HEATER IS ZERO. SOME TIME AFTER YEAR 2016, THE BATH HEATER WILL NEED TO BE STARTED UP TO PROVIDE ADDITIONAL PRODUCTION HEATING. THE FLOW CONTROLLER SHALL BE UNDER DCS SUPERVISION TO OPTIMIZE BATH HEATER CAPACITY.
 6. ALL EQUIPMENT DATA FROM YEAR 2011 HYSYS SIMULATION.

LEGEND:
XX - STREAM NUMBER

P-76001A/B
 SCRUBBER PUMPS
 RATED: 48 GPM EACH
 2x100%


K-76001
 1st STAGE COMPRESSOR
 12,380 ACFM
 20,390 HP

PHASE 2

NO.	DATE	REVISION	BY	CHK	APPD	NO.	DATE	REVISION	BY	CHK	APPD
A	07/06	ISSUED FOR CLIENT REVIEW PER EPT 36335424-02	WW	AL	WM						
B	10/06	REISSUED FOR CLIENT REVIEW PER EPT 36335424-02	WW	AL	WM						
C	11/06	ISSUED FOR PRELIMINARY PHA PER EPT 36335424-02	WW	AL	WM						
D	02/07	ISSUED FOR PIPING DESIGN PER EPT 36335424-02	AL	RH	WM						
E	04/07	ISSUED FOR DEFINE PHASE ESTIMATE	OK	DJS	AL						

REV	WP ENGR MGR	WP PROJ LEADER	BPXA TA	BPXA TA	BPXA ENGR MGR	BPXA PROJ LEADER
SIGN						
DATE						

ENGINEERING RECORD	DATE
DRN: RQ	
DSGN:	
CHK:	
APP:	
SCALE:	NONE

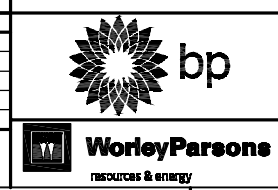

TITLE OF DRAWING: WPZ PROCESS FLOW PROCESS FLOW DIAGRAM SEPARATION/COMPRESSION/DEHYDRATION			
WORK ORDER	DRAWING NUMBER	REV	SHEET
	FS-WPZ-00006	E	001
MODULE: GEN	JOB NO.: 10741002		OF 002



USER: T_CAGER FILE INFO: R:\BPXA\W0A\WPZGPPA\Phase_2\FS-WPZ-00006-001.dwg
 TIME: 16:45:56
 DATE: 04-30-07

This datasheet and the design it covers are the property of WORLEYPARSONS. They are merely loaned on the borrowers' expressed agreement that they will not be reproduced, copied, loaned nor used except in the limited way and private use permitted by any written consent given by the lender to the borrower.

REVISIONS	NO.	DATE	BY	CK	APP	DESCRIPTION	Code: ASME SECTION VIII DIV.			
	B	10/24/06	WW	AL		ISSUED FOR DESIGN				
	C	11/20/06	WW	AL	AL	ISSUED FOR DESIGN	Code Certificate Req'd	Code Stamp		
	D	06/12/07	JC/DW			ISSUED FOR DESIGN	National Board Registration			
Accessories by Fabricator:							YES	NO		
Vessel Davit Mark No.							X		Opr Pressure (Intl)	350 psig at 105 °F
Ladder & Platform Clips							X		Des Pressure (Intl)	450 psig at 200 °F
Pipe Support & Pipe Guide Clips								X	Des Pressure (Ext)	FV psia at 200 °F
Insulation Supports							X		Minimum Design Metal Temp	-50 °F (Note 2) at 450 psig
Fireproofing Supports							X		Corrosion Allowances:	Shell 1/8" Heads 1/8" Noz
Grounding Lugs							X		Liquid Level for Design	at Sp Gr
Lifting Lugs							X		MAWP	psig at °F limited by
NOZZLES & COUPLINGS SCHEDULE							Shop Hydro			psig °F Min Horiz Posn
Projections of Radial Nozzles & Manholes Are From Vessel Centerline to Extreme Face of Flange							Field Hydro New			psig °F Min Opr Posn
							Field Hydro Crsn			psig °F Min Opr Posn
Item	No.	Size	Proj	Service		PWHT	per Radiograph RT-			
N1	1	36"	FLG	Feed		Joint Eff:	Shell	Heads		
N2	1	24"	FLG	Liquid Outlet		Allow Stress	psig at Design Temp			
N3	1	30"	FLG	Vapor Outlet		Shell	LTCS + epoxy coating inside + PWHT (NACE)			
N5	1	4"	FLG	Vent		Heads	LTCS + epoxy coating inside + PWHT (NACE)			
N6	1	18"	FLG	PSV (Note 1)		Supports	LTCS			
N7A-E	8	3"	FLG	Sandjet Water Inlets		Internals	316SS Trays			
N7F-H	8	3"	FLG	Sandjet Slurry Outlets		Bolts (Intl)	Nuts			
N8A-B	2	3"	FLG	Level Transmitter (guided wave)		Bolts (Ext)	Nuts			
N9A-B	2	3"	FLG	Level Gauge/Transmitter (magnetic)		Flanges	Cplg			
N10	1	2"	FLG	Pressure Differential Transmitter		Nozzle Necks				
N11	1	2"	FLG	Temperature Transmitter		Gaskets				
N12 A-C	3	2"	FLG	Pressure Transmitter		Capacity	ft ³			
N13A-B	2	4"	FLG	Drain		Fab Wt	lbs	Empty Wt	lbs	
N14 A-B	2	3"	FLG	Level Switch		Tray Wt	lbs	Packing Wt	lbs	
N15 A-B	2	6"	FLG	Level Transmitter		Opr Wt	lbs	Test Wt	lbs	
M1, M2	2	30"	FLG	Manway with Swing Davits		Paint				
Rating	300 #	Facing	RF	Finish	Smooth	Insulation	4" (for winterization)			
See Plans For True Orientation							Fireproofing	Yes		

NOTES:

- Relief valve nozzle size is preliminary and subject to change.
- Minimum site temperature is -50 °F.
- Number and size of sandjet nozzles to be confirmed upon system selection.

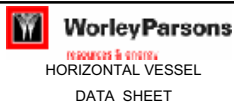
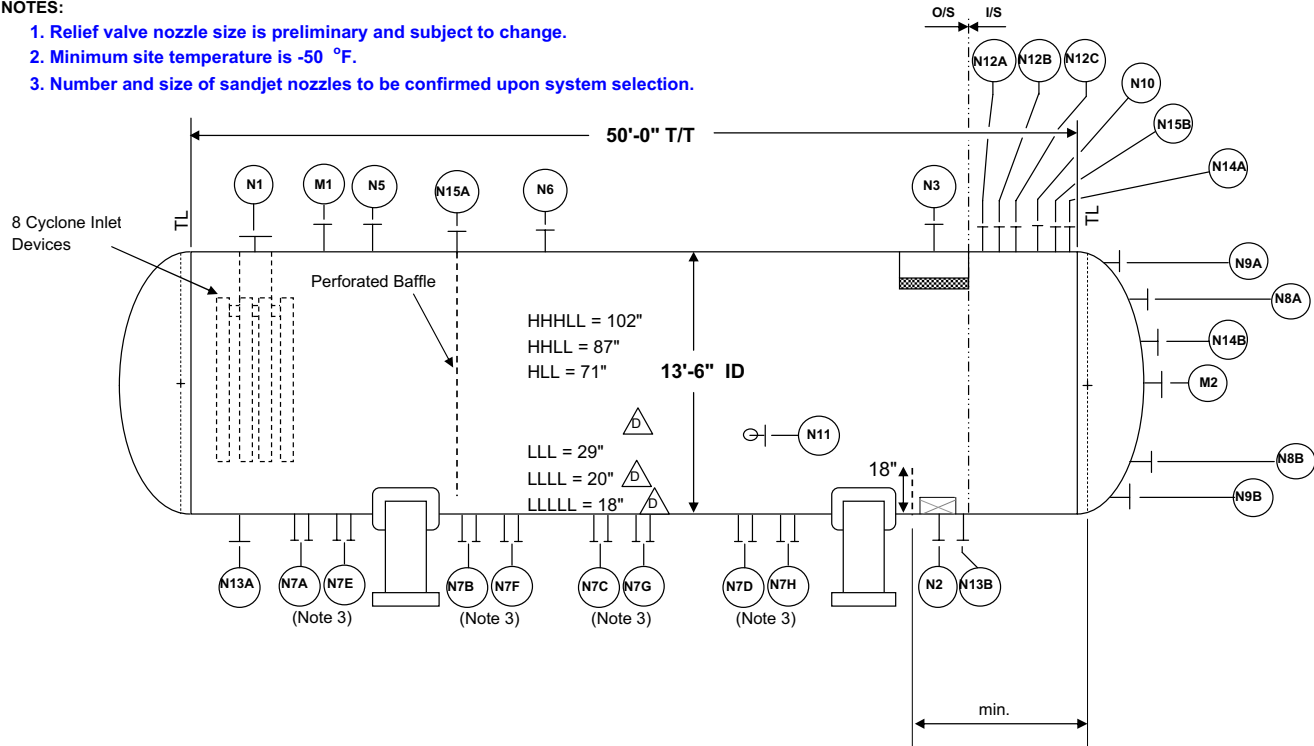


BPXA ZPAD GAS PARTIAL PROCESSING (GPP)
VSP-Z6011
Inlet Separator

SHEET	OF	JOB NUMBER
1	1	10741003
DRAWING NUMBER		REV
DAS-TD-VSP-Z6011		D

This datasheet and the design it covers are the property of WORLEYPARSONS. They are merely loaned on the borrowers' expressed agreement that they will not be reproduced, copied, loaned nor used except in the limited way and private use permitted by any written consent given by the lender to the borrower.

REVISIONS	NO.	DATE	BY	CK	APP	DESCRIPTION	Code: ASME SECTION VIII							
	C	2/12/2007	JC	AL	AL									
	D	2/22/2007	OK											
	E	7/19/2007	OK			ISSUED FOR DESIGN								
VS-Z6001 1ST STAGE SUCTION SCRUBBER							Code Certificate Req'd	Code Stamp						
<p style="text-align: center;">VS-Z6001 1ST STAGE SUCTION SCRUBBER</p> <p style="text-align: center;">Axial Flow Cyclones</p> <p style="text-align: center;">VORTEX BREAKER</p> <p style="text-align: center;">11'-6" ID</p> <p style="text-align: center;">HHLL 39"</p> <p style="text-align: center;">HLL 19"</p> <p style="text-align: center;">LLL 9"</p> <p style="text-align: center;">LLLL 6"</p> <p style="text-align: center;">111"</p> <p style="text-align: center;">14'-3" T/T</p> <p style="text-align: center;">34.5"</p> <p style="text-align: center;">18"</p> <p style="text-align: center;">50"</p> <p style="text-align: center;">49.5"</p> <p style="text-align: center;">19"</p> <p style="text-align: center;">45°</p> <p style="text-align: center;">M2, N1, N4, N2, N7A, N5A, N6A, N7B, N8, N5B, M1, N3</p>							National Board Registration							
							Opr Pressure (Intl)	ΔE 347	psig	at	ΔE 105	°F		
							Des Pressure (Intl)	ΔE 650	psig	at	ΔE 300	°F		
							Des Pressure (Ext)	FV	psi	at	ΔE 300	°F		
							Minimum Design Metal Temp	-20	°F	at	ΔE 650	psig		
							Corrosion Allow:	Shell 1/8"	Heads 1/8"	Noz				
							Liquid Level for Design			at Sp Gr	0.98			
							MAWP		psig	at		°F limited by		
							MAP N&C		psig	at		Amb Temp limited by		
							Shop Hydro		psig			°F	Min Horiz Posn	
							Field Hydro New		psig			°F	Min Opr Posn	
							Field Hydro Crsn		psig			°F	Min Opr Posn	
							PWHT		per				Radiograph RT-	
							Joint Eff:		Shell			Heads		
							Allow Stress			psi		at Design Temp		
MATERIALS	Shell	CS (NACE) + PWHT+ internal epoxy coat					ΔE							
	Heads	CS (NACE) + PWHT+ internal epoxy coat					ΔE							
	Supports	CS												
	Internals	316 SS						Trays						
	Bolts (Intl)							Nuts						
	Bolts (Ext)							Nuts						
	Flanges							Cplg						
	Nozzle Necks													
	Gaskets													
	Capacity							ft ³						
Empty Wt		lbs		Fab Wt		lbs								
Packing Wt		lbs		Tray Wt		lbs								
Opr Wt		lbs		Test Wt		lbs								
Paint														
Insulation														
Fireproofing														
Accessories by Fabricator:														
						YES	NO							
Vessel Davit	Mark No.						X							
Ladder & Platform Clips							X							
Pipe Support & Pipe Guide Clips							X							
Insulation Supports							X							
Fireproofing Supports							X							
Grounding Lugs						X								
Lifting Lugs						X								
NOZZLES & COUPLINGS SCHEDULE														
Projections of Radial Nozzles & Manholes Are From Vessel Centerline to Extreme Face of Flange														
Item	No.	Size	Proj	Service										
N1	1	30"		Vapor Exit										
N2	1	30"		Feed										
N3	1	3"		Liquid Exit										
N4	1	2"		Vent										
N5 A/B	2	3"		Level Gauge/Transmitter										
N6 A/B	2	3"		Level Transmitter										
N7 A/B	2	3"		Level Transmitter										
N8	1	2"		Purge										
M1	1	24"		Manway										
M2	1	24"		Manway										
Rating	300#		Facing	RF		Finish								
See Plans For True Orientation														
NOTES:														
1) LLL and skirt height are set to satisfy NPSH requirement for Scrubber Pump.														
2) HLL is set to start Scrubber Pump and HHLL is set to start spare pump.														
3) Feed nozzle location and HHLL will be verified and determined by contractor.														
WorleyParsons resources & services VERTICAL VESSEL DATA SHEET		BPXA ZPAD GAS PARTIAL PROCESSING (GPP) VS-Z6001 1ST STAGE SUCTION SCRUBBER				SHEET 1	OF 1	JOB NUMBER 10741230						
DRAWING NUMBER DAS-TD-VS-Z6001						REV E								

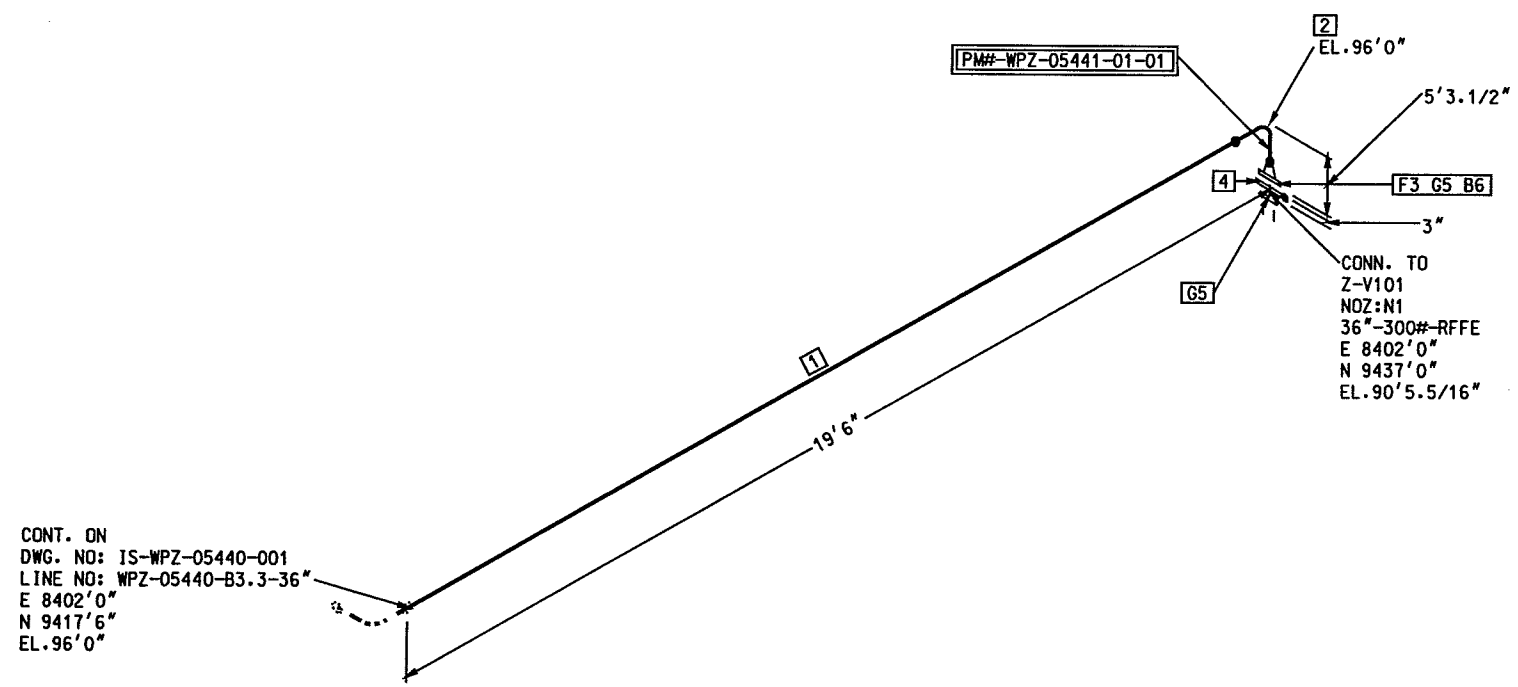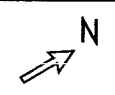

CONT. ON
 DWG. NO: IS-WPZ-05440-001
 LINE NO: WPZ-05440-B3.3-36"
 E 8402'0"
 N 9417'6"
 EL.96'0"

SHOP MATERIALS

PT NO	COMPONENT DESCRIPTION	SIZE (INS)	STOCK NO.	QTY
PIPE				
1	PIPE, EFW, 100% XRAY, STL, ASTM A671 GR CC65 CL 12, IMPACT TESTED, BE, 0.750" WALL	36	059420100620000	15.0'
FITTINGS				
2	90 DEG LR ELBOW, STL, ASTM A420 GR WPL6, WELDED, BW, 0.750" WALL	36	222010100620000	1
FLANGES				
3	FLANGE, WN, PER ASME B16.47 SERIES A, STL, ASTM A350 GR LF2 CL 1, RF, CL300, 0.750" WALL	36	121100103620000	1

FIELD MATERIALS


PT NO	COMPONENT DESCRIPTION	SIZE (INS)	STOCK NO.	QTY
FITTINGS				
4	SLIP BLANK AND SPACER, ASME B16.47 SERIES A, STL, ASTM A516 GR 70, IMPACT TESTED OR A350 LF2 CL1, RF, CL300, PER STD-PD-00-00067	36	55807060300SBP1	1
GASKETS				
5	GASKET, SPIRAL WOUND, ASME B16.47 SERIES A, 304 SS WITH 304SS INNER/STL OUTER RINGS & FLEX GRAPH FILLER, 1/8" THK, CL300, FLEXITALLIC STYLE CG1	36	7SC3302030000F3	2
BOLTS				
6	STUD BOLT W/2 HVY HEX NUTS, ASTM A320 GR L7 / ASTM A194 GR 7, 16.5" BOLT LENGTH	2	870010000000000	32

PIECE MARK NO.
 PM#-WPZ-05441-01-01

NOTES: 1. FIELD VERIFY ALL ELEVATIONS AND DIMENSIONS PRIOR TO FABRICATION.
 2. FFU = FIELD FIT-UP. WHEN INDICATED, ADD 1'-0" EXTRA TO PIPE LENGTH SHOWN. FIELD TO DETERMINE CUT LENGTH AT FIELD WELD.

ISOMETRIC CHECK PRINT		
ISO STATUS	INITIAL	DATE
DESIGNER REVIEW		
AREA LEAD		
STRESS CHECK		
FROM CHECK		
PDS UPDATE		
2D UPDATE		
BACK CHECK		
SIGN OFF		

DESIGN DATA				REVISION				SERVICE: PROCESS LIQUID	
LEGEND:	CODE: ANSI-B31.3	CLEAN: PER SPEC	WELD PROC: PER SPEC	NO	DATE	DESCRIPTION	BY	CHK	APP
<input type="checkbox"/> DENOTES ITEM NUMBERS	CLASS: B5.3	PAINT: PER SPEC	STRESS RELIEVE:			ISSUED FOR CONSTRUCTION PER EPT			
<input type="checkbox"/> DENOTES SPOOL NUMBERS	DES PRESS:	INSULATION:	NUMBER OF WELDS:						
<input type="checkbox"/> DENOTES TIE-IN POINT	DES TEMP:	HYDRO TEST:							
	OPER PRESS:	X-RAY QTY: PER SPEC	PLAN NO.:						
	OPER TEMP:	INTERP: ANSI-B31.3	P&ID NO.:						
	LINE NO.:								

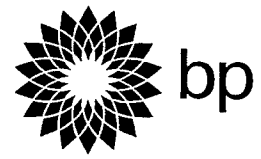

TITLE OF DRAWING:				
WOA - ISOMETRIC				
MODULE	UNIT CODE	DRAWING NUMBER	SHEET	REV. NO.
	WPZ	IS-WPZ-05441	001	